


4	AS CONSTRUCTED	M.T.S	05-08-20
3	TEMP RETARDING BASIN & 1050DIA PIPE REMOVED	M.T.S	25-06-20
2	BIKE PATH ALIGNMENT AMENDED ON CROWN DRIVE	M.T.S	01-06-20
1	GAS/ WATER CONDUITS, DRAINAGE AND EASEMENT AMENDED	M.T.S	14-10-19
0	ISSUED FOR CONSTRUCTION	M.T.S	16-09-19
C	SWD PITS 36 & 37 SHIFTED SOUTH	M.T.S	23-08-19
B	ISSUED FOR APPROVAL	M.T.S	26-03-19
A	ISSUED FOR TENDER	M.T.S	15-03-19
Rev	Amendments	Approved	Date

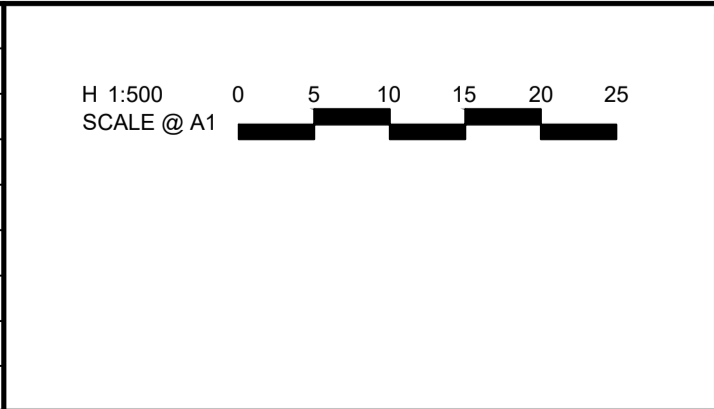

**KERANI HEIGHTS  
STAGE 1  
ROAD & DRAINAGE  
SERVICES PLAN  
CITY OF MELTON  
PGG (PLUMPTON 2) PTY LTD**

**AS CONSTRUCTED**

Drg No  
**305536CR202**

Rev  
**4**

file name: 305536CR202.dwg, layout name: CR202, created by: Pate Wilson  
file location: G:\305536\305536.dwg, ACAD plot date: 05/08/2020 3:05 PM Sheet 4 of 30 Sheets